




① SOUTH CORRIDOR- NORTH ELEVATION
SCALE 1/4" = 1'-0"

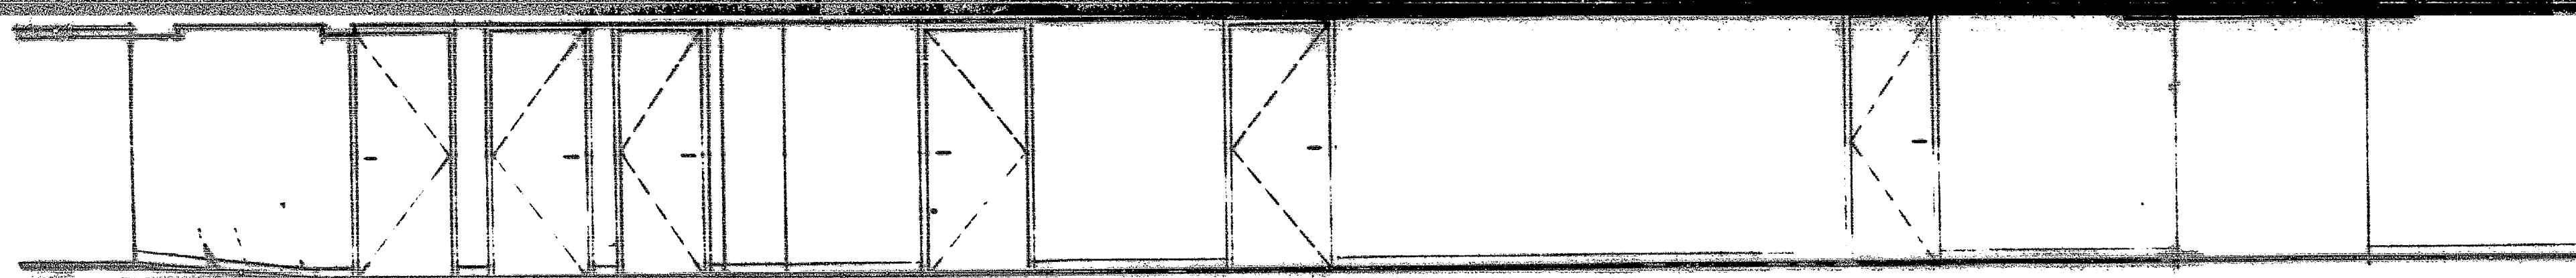


② SOUTH CORRIDOR- NORTH ELEVATION
SCALE 1/4" = 1'-0"

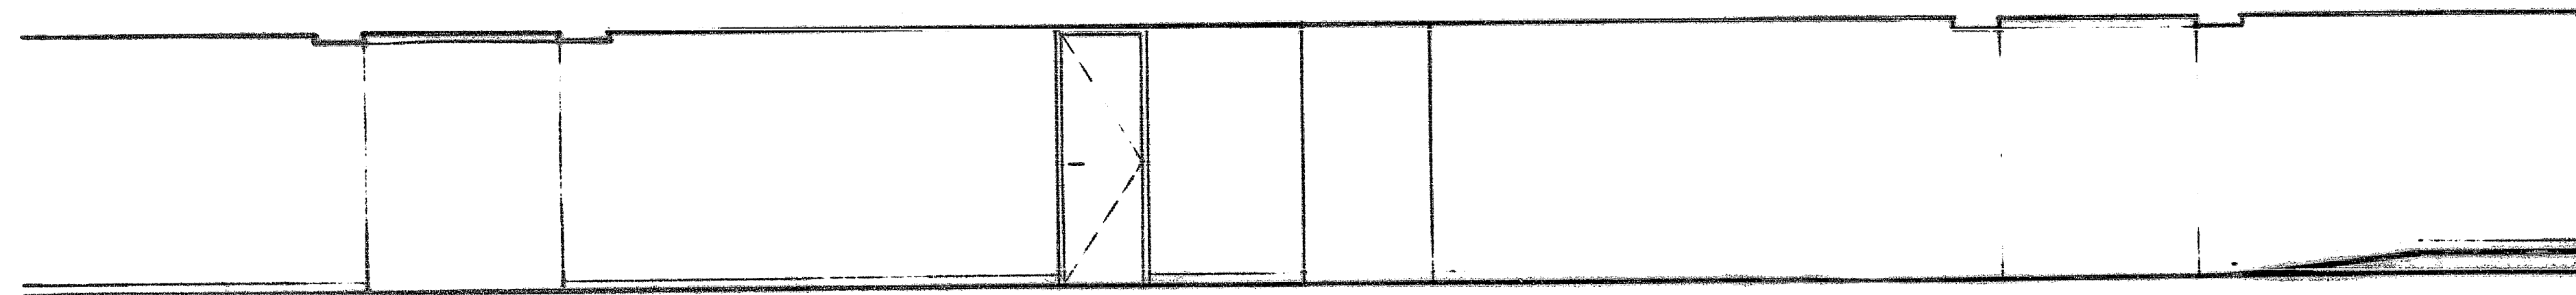


③ SOUTH CORRIDOR- SOUTH ELEVATION
SCALE 1/4" = 1'-0"

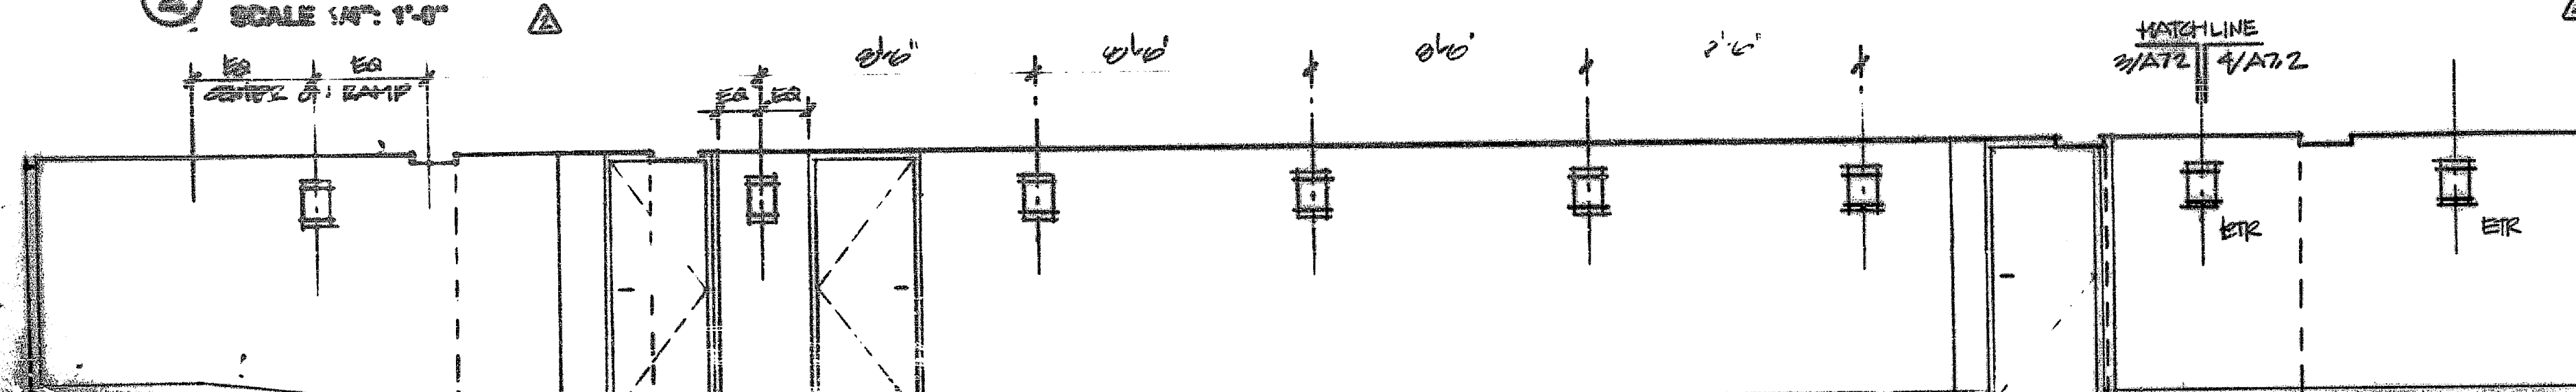


④ SOUTH CORRIDOR- SOUTH ELEVATION
SCALE 1/4" = 1'-0"

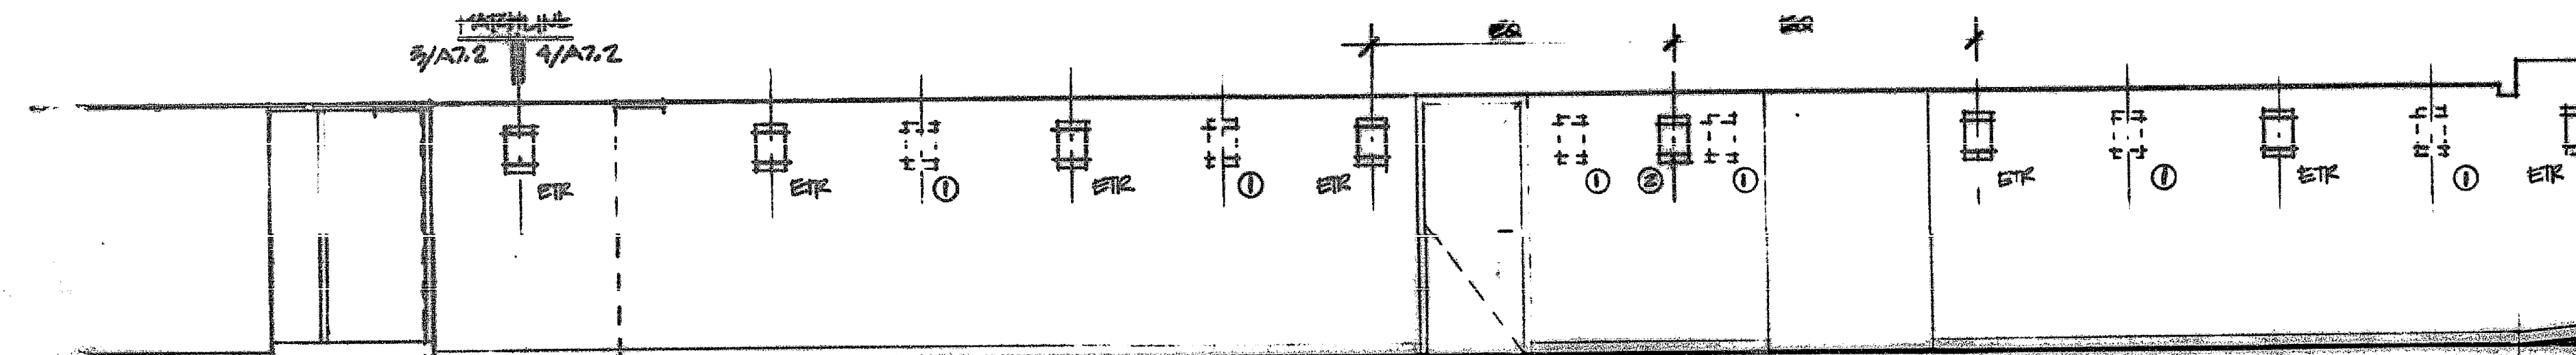

⑤ ELEVATION AT VESTIBULE
SCALE 1/4" = 1'-0"

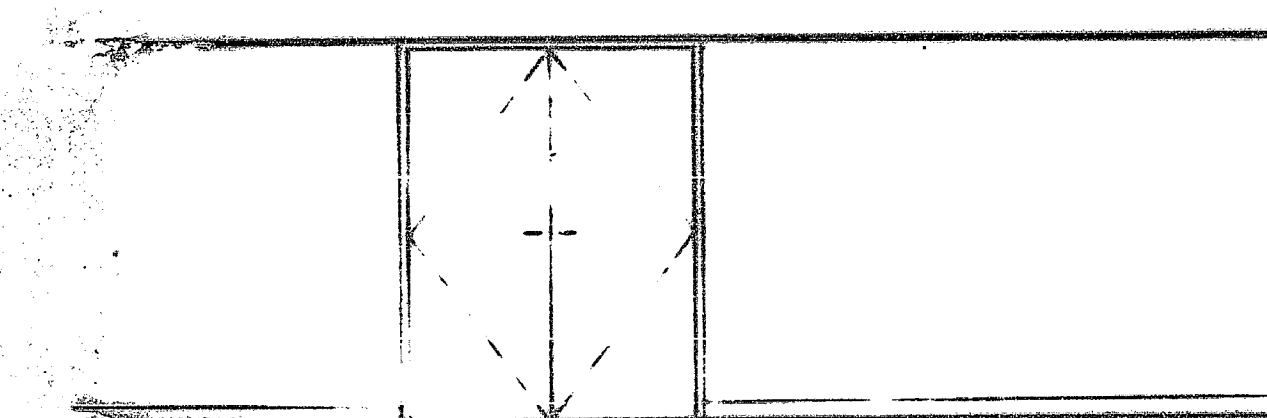

- ① EXISTING FIXTURE & BOX TO BE REMOVED, PATCH & PAINT AREAS TO MATCH SURROUNDING SURFACES
② RELOCATE EXISTING FIXTURE TO LOCATION SHOWN, PATCH & PAINT AREAS TO MATCH SURROUNDING SURFACES
ETR EXISTING TO REMAIN
NOTE - UNLESS NOTED ALL FIXTURES ARE NEWLY INSTALLED, FURNISHED BY OWNER

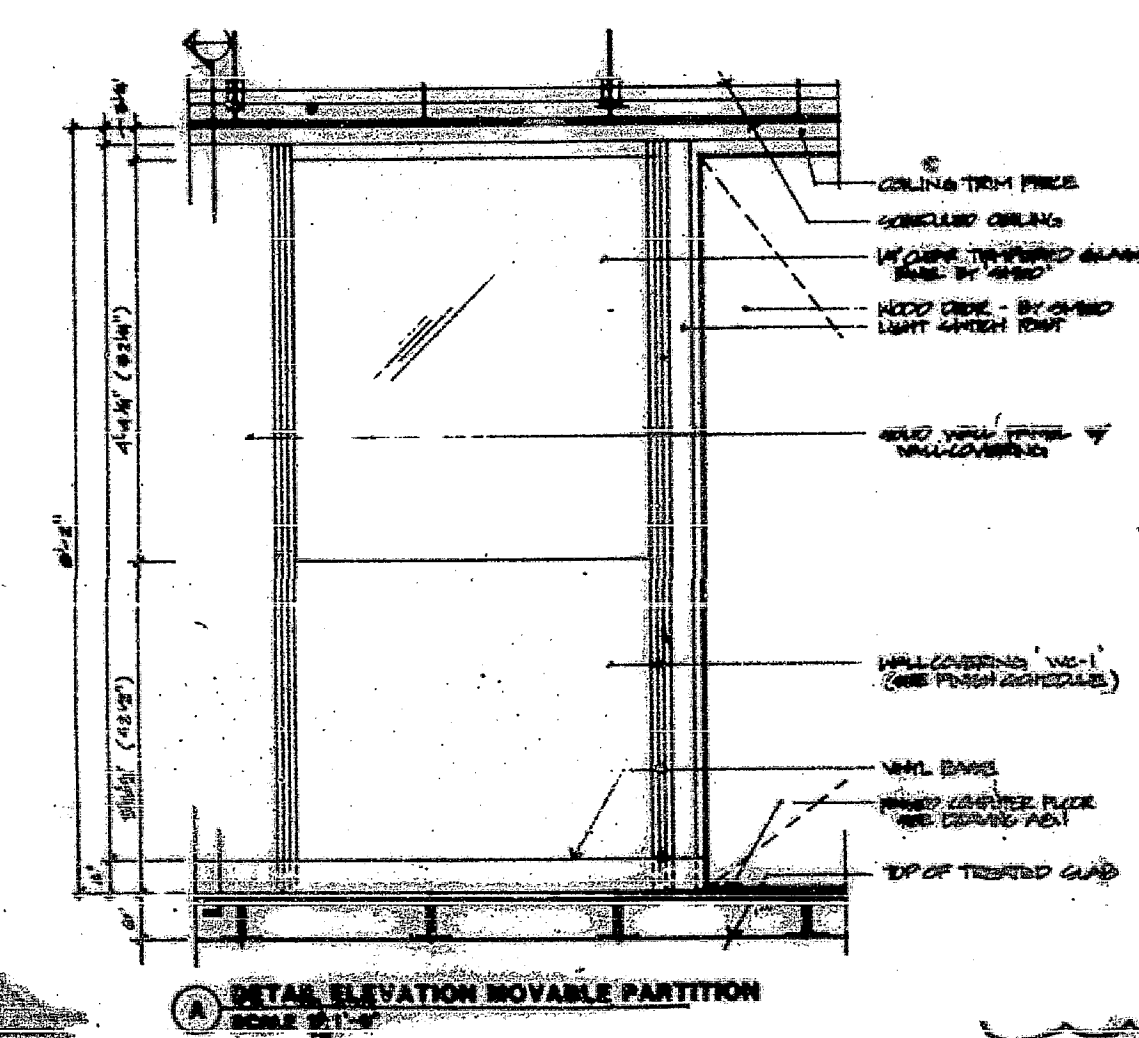

WPG DESIGN GROUP
ARCHITECTS
INTERIOR DESIGNERS
300 WEST AVENUE
NEW YORK, NEW YORK 10017
212 682-1111


Signed: *[Signature]*
Ilya Asanovich
NTX Interiors Inc.
General Contractor
Certified As-Built

No.	Revision Date	Issued Record
1	11.14.94	REMOVED AS PER PORT AUTHORITY COMMENTS 2ND SUBMISSION
2	12.9.94	REMOVED AS PER TUNANT REQUEST
3	5.1.95	"AS-BUILT"

INTERIOR
ELEVATIONS

T.A.A. #941154

Scale: 1/4" = 1'-0"
Project No.: 94109
Date: 5/1/95

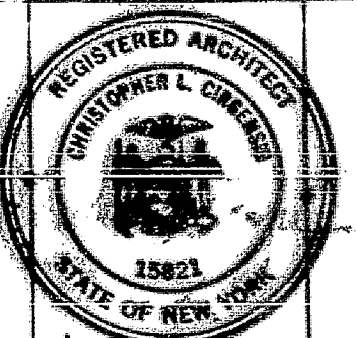

A7.2